


Northstar Limited
 Title : 652402
 Total Area : 1.6593ha
 Zone : Coastal Living
 All asbuilt data supplied by Far North Roding Limited.
 Coordinates in terms of NZGD Mt Eden 2000
 All heights are in terms of One Tree Point 1964
 Origin of heights IS SO 23863 (EPTV) RL 10.546

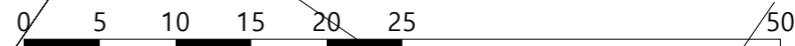

Dir : FNR ASBUILT SEWER
 Scale @ A3 : 1:500
 Date : 28/11/2024

Sheet No: 2 of 4
REF : 8552

DONALDSONS
 REGISTERED LAND SURVEYORS

ASBUILT OF SEWER AT ALBATROSS ALLEY
RC: 2300507-RMAEPA/A