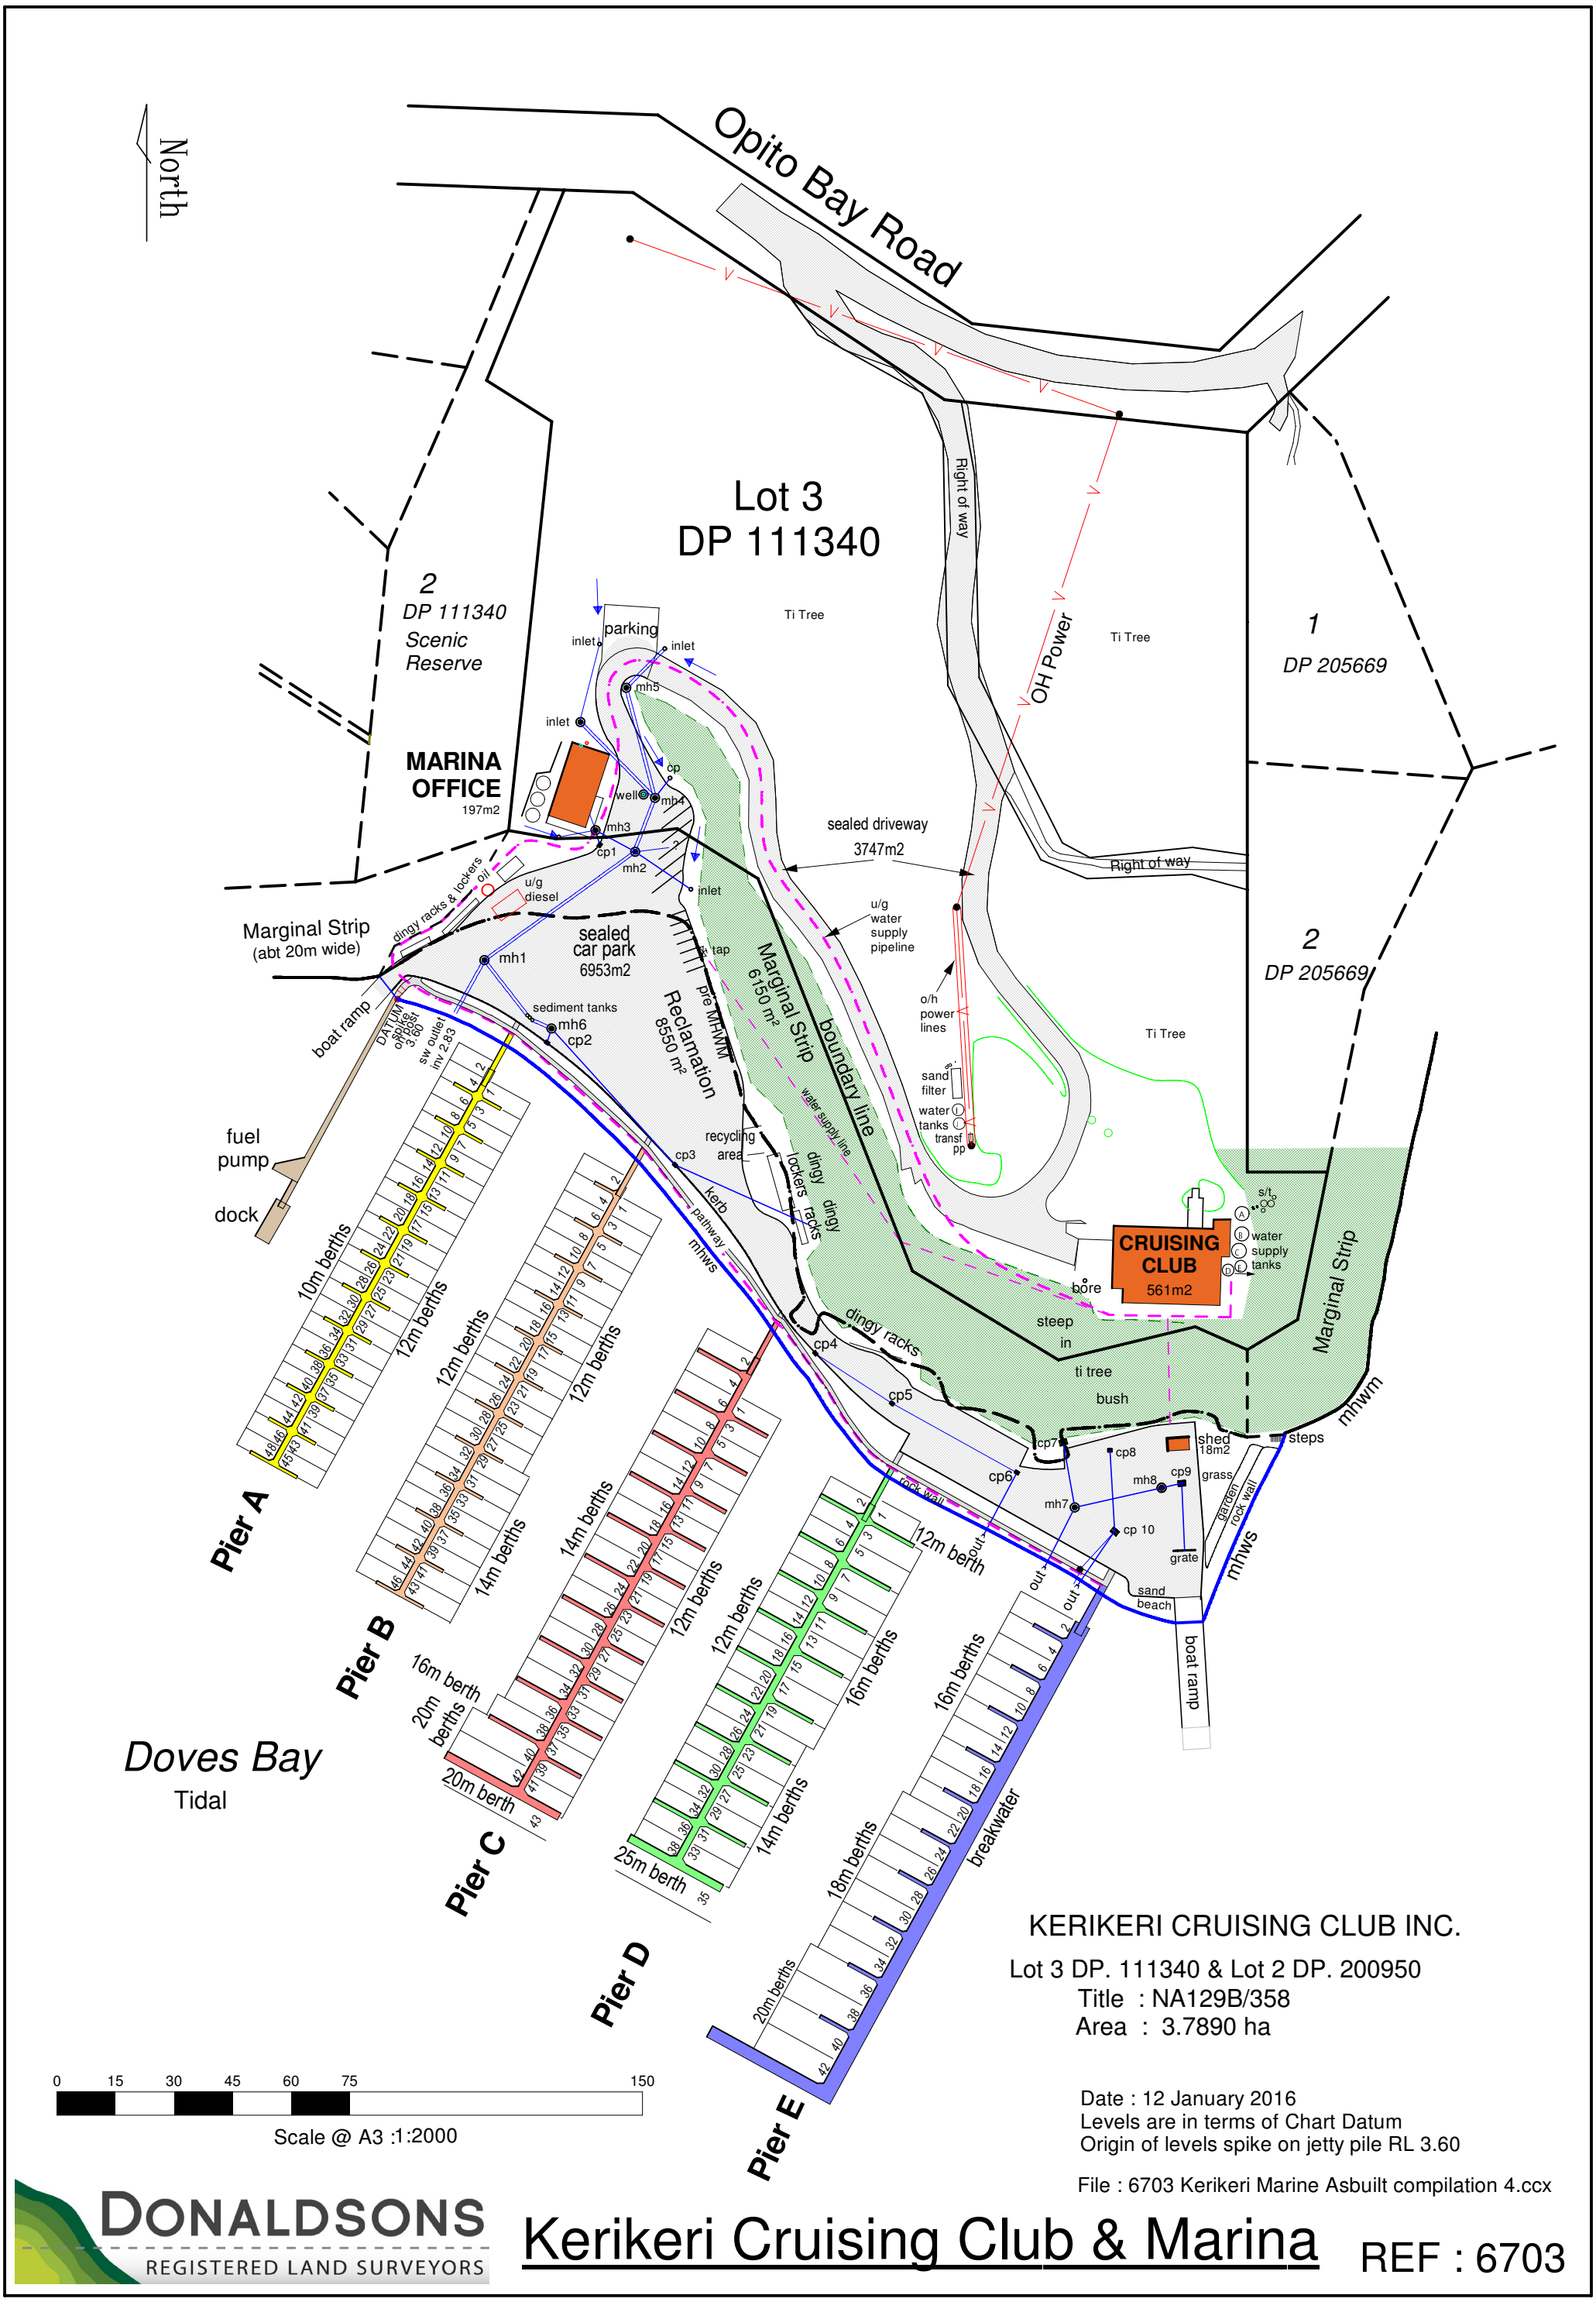

KERIKERI CRUISING CLUB INC.

Lot 3 DP. 111340 & Lot 2 DP. 200950
Title : NA129B/358
Area : 3.7890 ha

Date : 12 January 2016
Levels are in terms of Chart Datum
Origin of levels spike on jetty pile RL 3.60

File : 6703 Kerikeri Marine Asbuilt compilation 4.ccx

DONALDSONS
REGISTERED LAND SURVEYORS

Kerikeri Cruising Club & Marina

REF : 6703

Land / engineering Surveyors & development planners - www.donaldsons.net.nz - em: info@donaldsons.net.nz - p:09 4079182