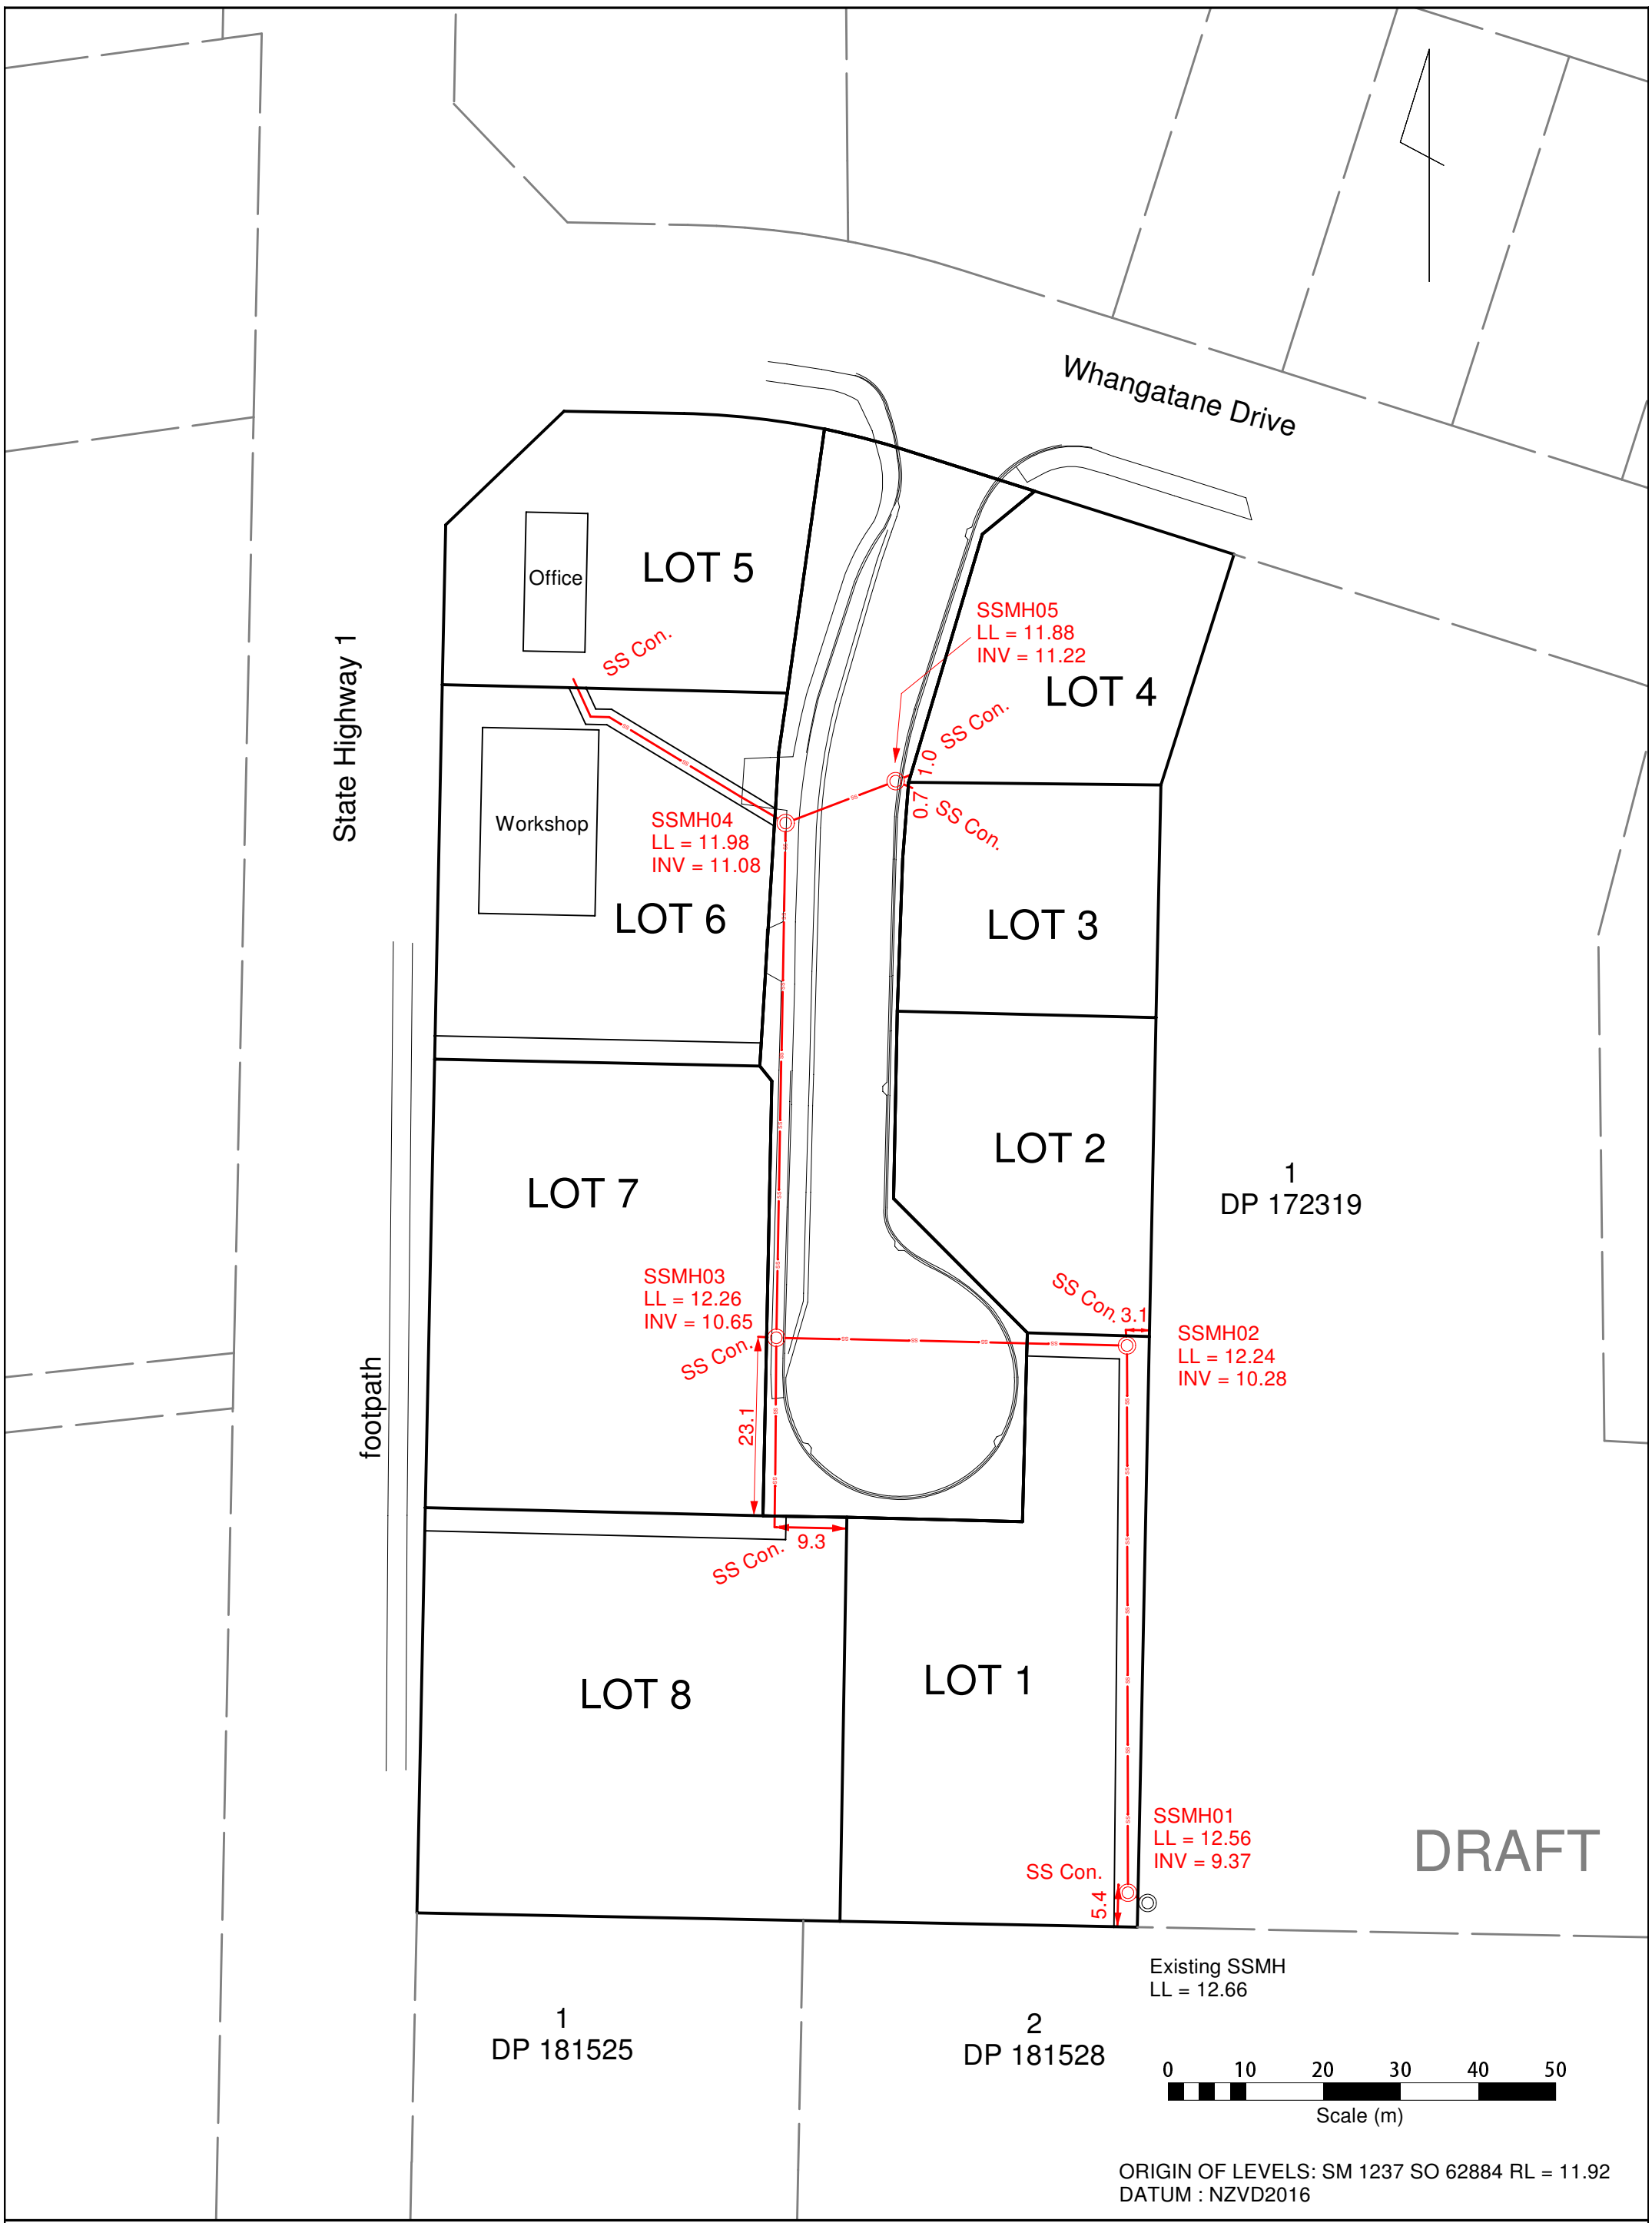

DONALDSONS
REGISTERED LAND SURVEYORS

Asbuilt - Sewer Reticulation

Scale @ A3 : 1:750
Date : 10/02/2022
REF : 7712